

ENGINEER'S CERTIFICATION

I, _____, hereby certify that:
 1. The information contained in this drawing / document is in compliance with approved drawings and design.
 2. The new water and sewerage works defined by this drawing have been designed and constructed in accordance with the SEQ Code.
 3. This represents an accurate record of as-constructed works
 4. I accept responsibility for the information contained in this drawing / document.

RPEQ (signature) RPEQ No. _____ Date: _____

REGISTERED SURVEYOR'S CERTIFICATION

I, LANCE EDMOND HAYES, hereby certify that the vertical and horizontal locations and dimensions shown on this plan are a true and correct record and were located by survey.

Registered Surveyor (sig.) Reg. Surveyor No. 55895 Date: 28/04/2021



TRIGONA



DRIVE

POLLEN STREET

LEAFCUTTER

CIRCUIT



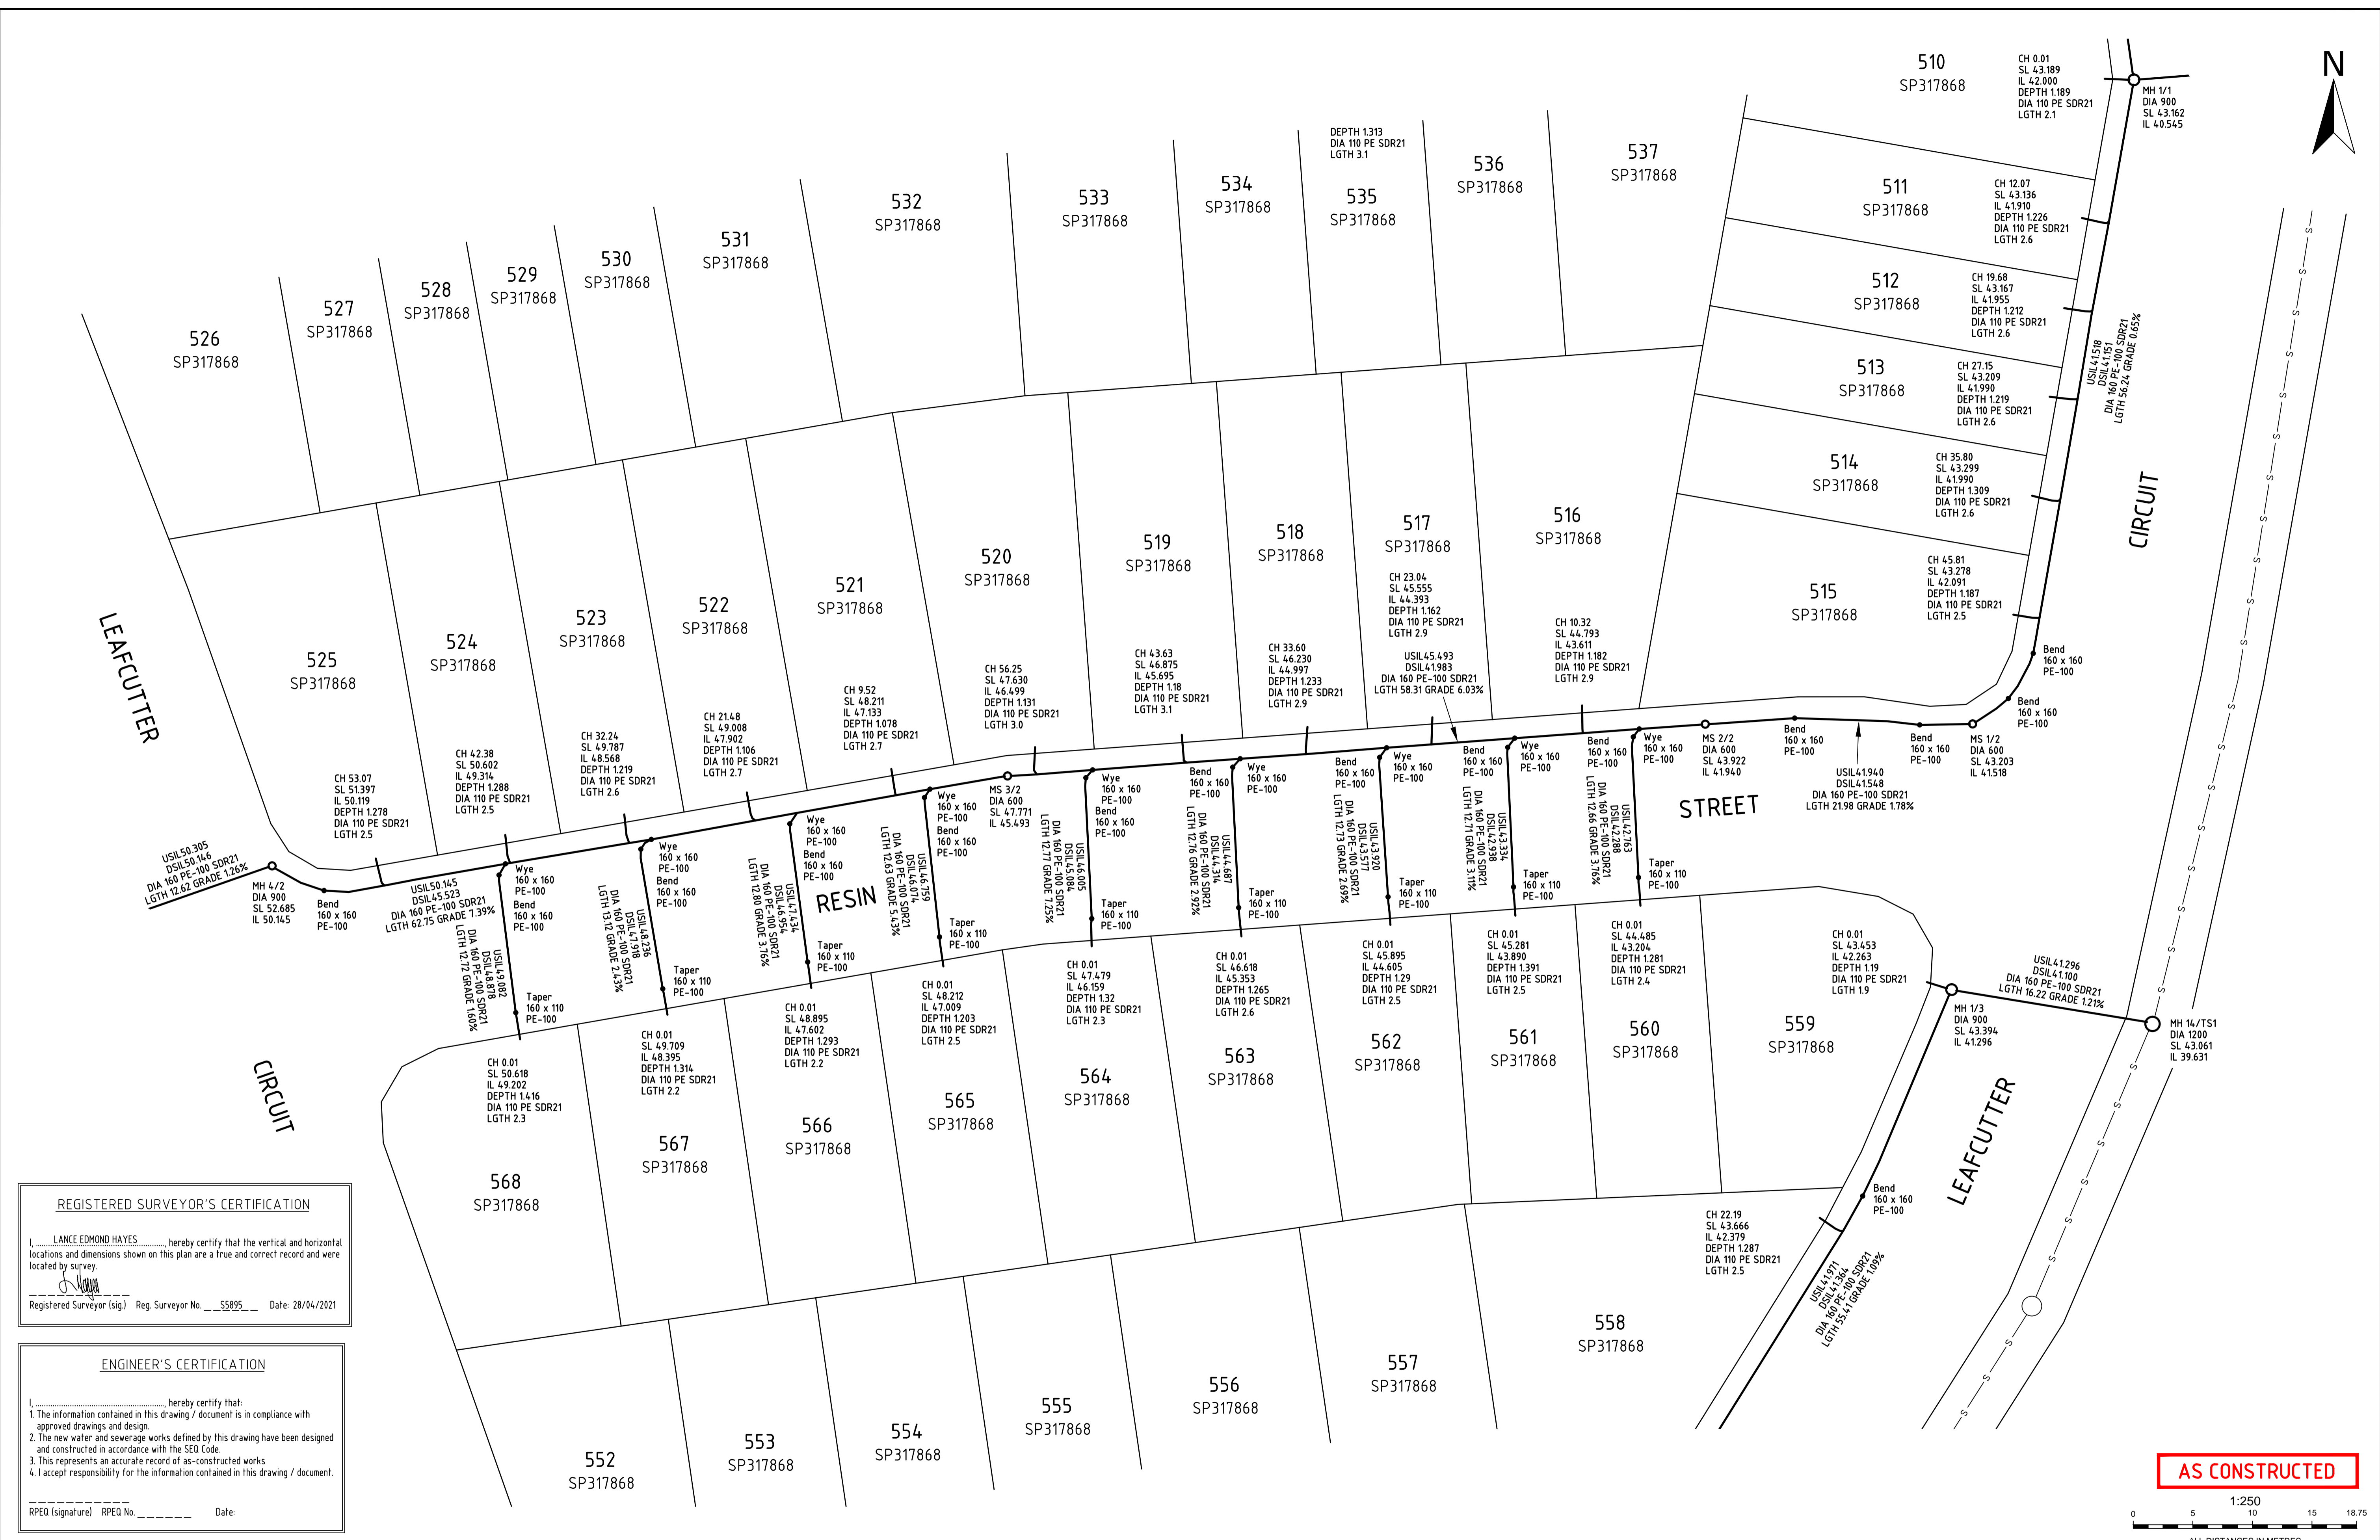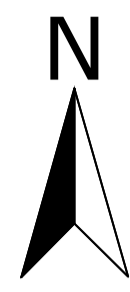

REGISTERED SURVEYOR'S CERTIFICATION

I, LANCE EDMOND HAYES, hereby certify that the vertical and horizontal locations and dimensions shown on this plan are a true and correct record and were located by survey.

Registered Surveyor (sig) [Signature] Reg. Surveyor No. S5895 Date: 28/04/2021


ENGINEER'S CERTIFICATION

I, _____, hereby certify that:

- The information contained in this drawing / document is in compliance with approved drawings and design.
- The new water and sewerage works defined by this drawing have been designed and constructed in accordance with the SEQ Code.
- This represents an accurate record of as-constructed works.
- I accept responsibility for the information contained in this drawing / document.

RPEQ (signature) _____ RPEQ No. _____ Date: _____

AS CONSTRUCTED

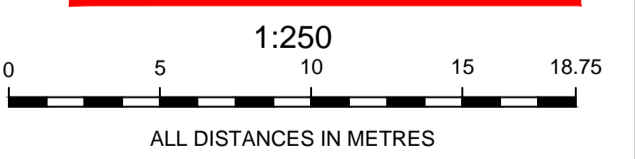

A1	1					
	1	28/04/2021	ORIGINAL ISSUE	QSD	BQG	BQG
	INDEX	DATE	REVISIONS	DRAWN	CHECKED	PASSED



DRAWN	QSD	28/04/2021
CHECKED	BQG	28/04/2021
PASSED	BQG	28/04/2021
	INITIALS	DATE



Queensland Urban Utilities

AS CONSTRUCTED SEWER
HAYFIELD STAGE 5
352 RIPLEY ROAD, RIPLEY

SCALE 1:250
SHEET 2 OF 4 SHEETS
DRAWING NO.
3366-0027-29-SEW

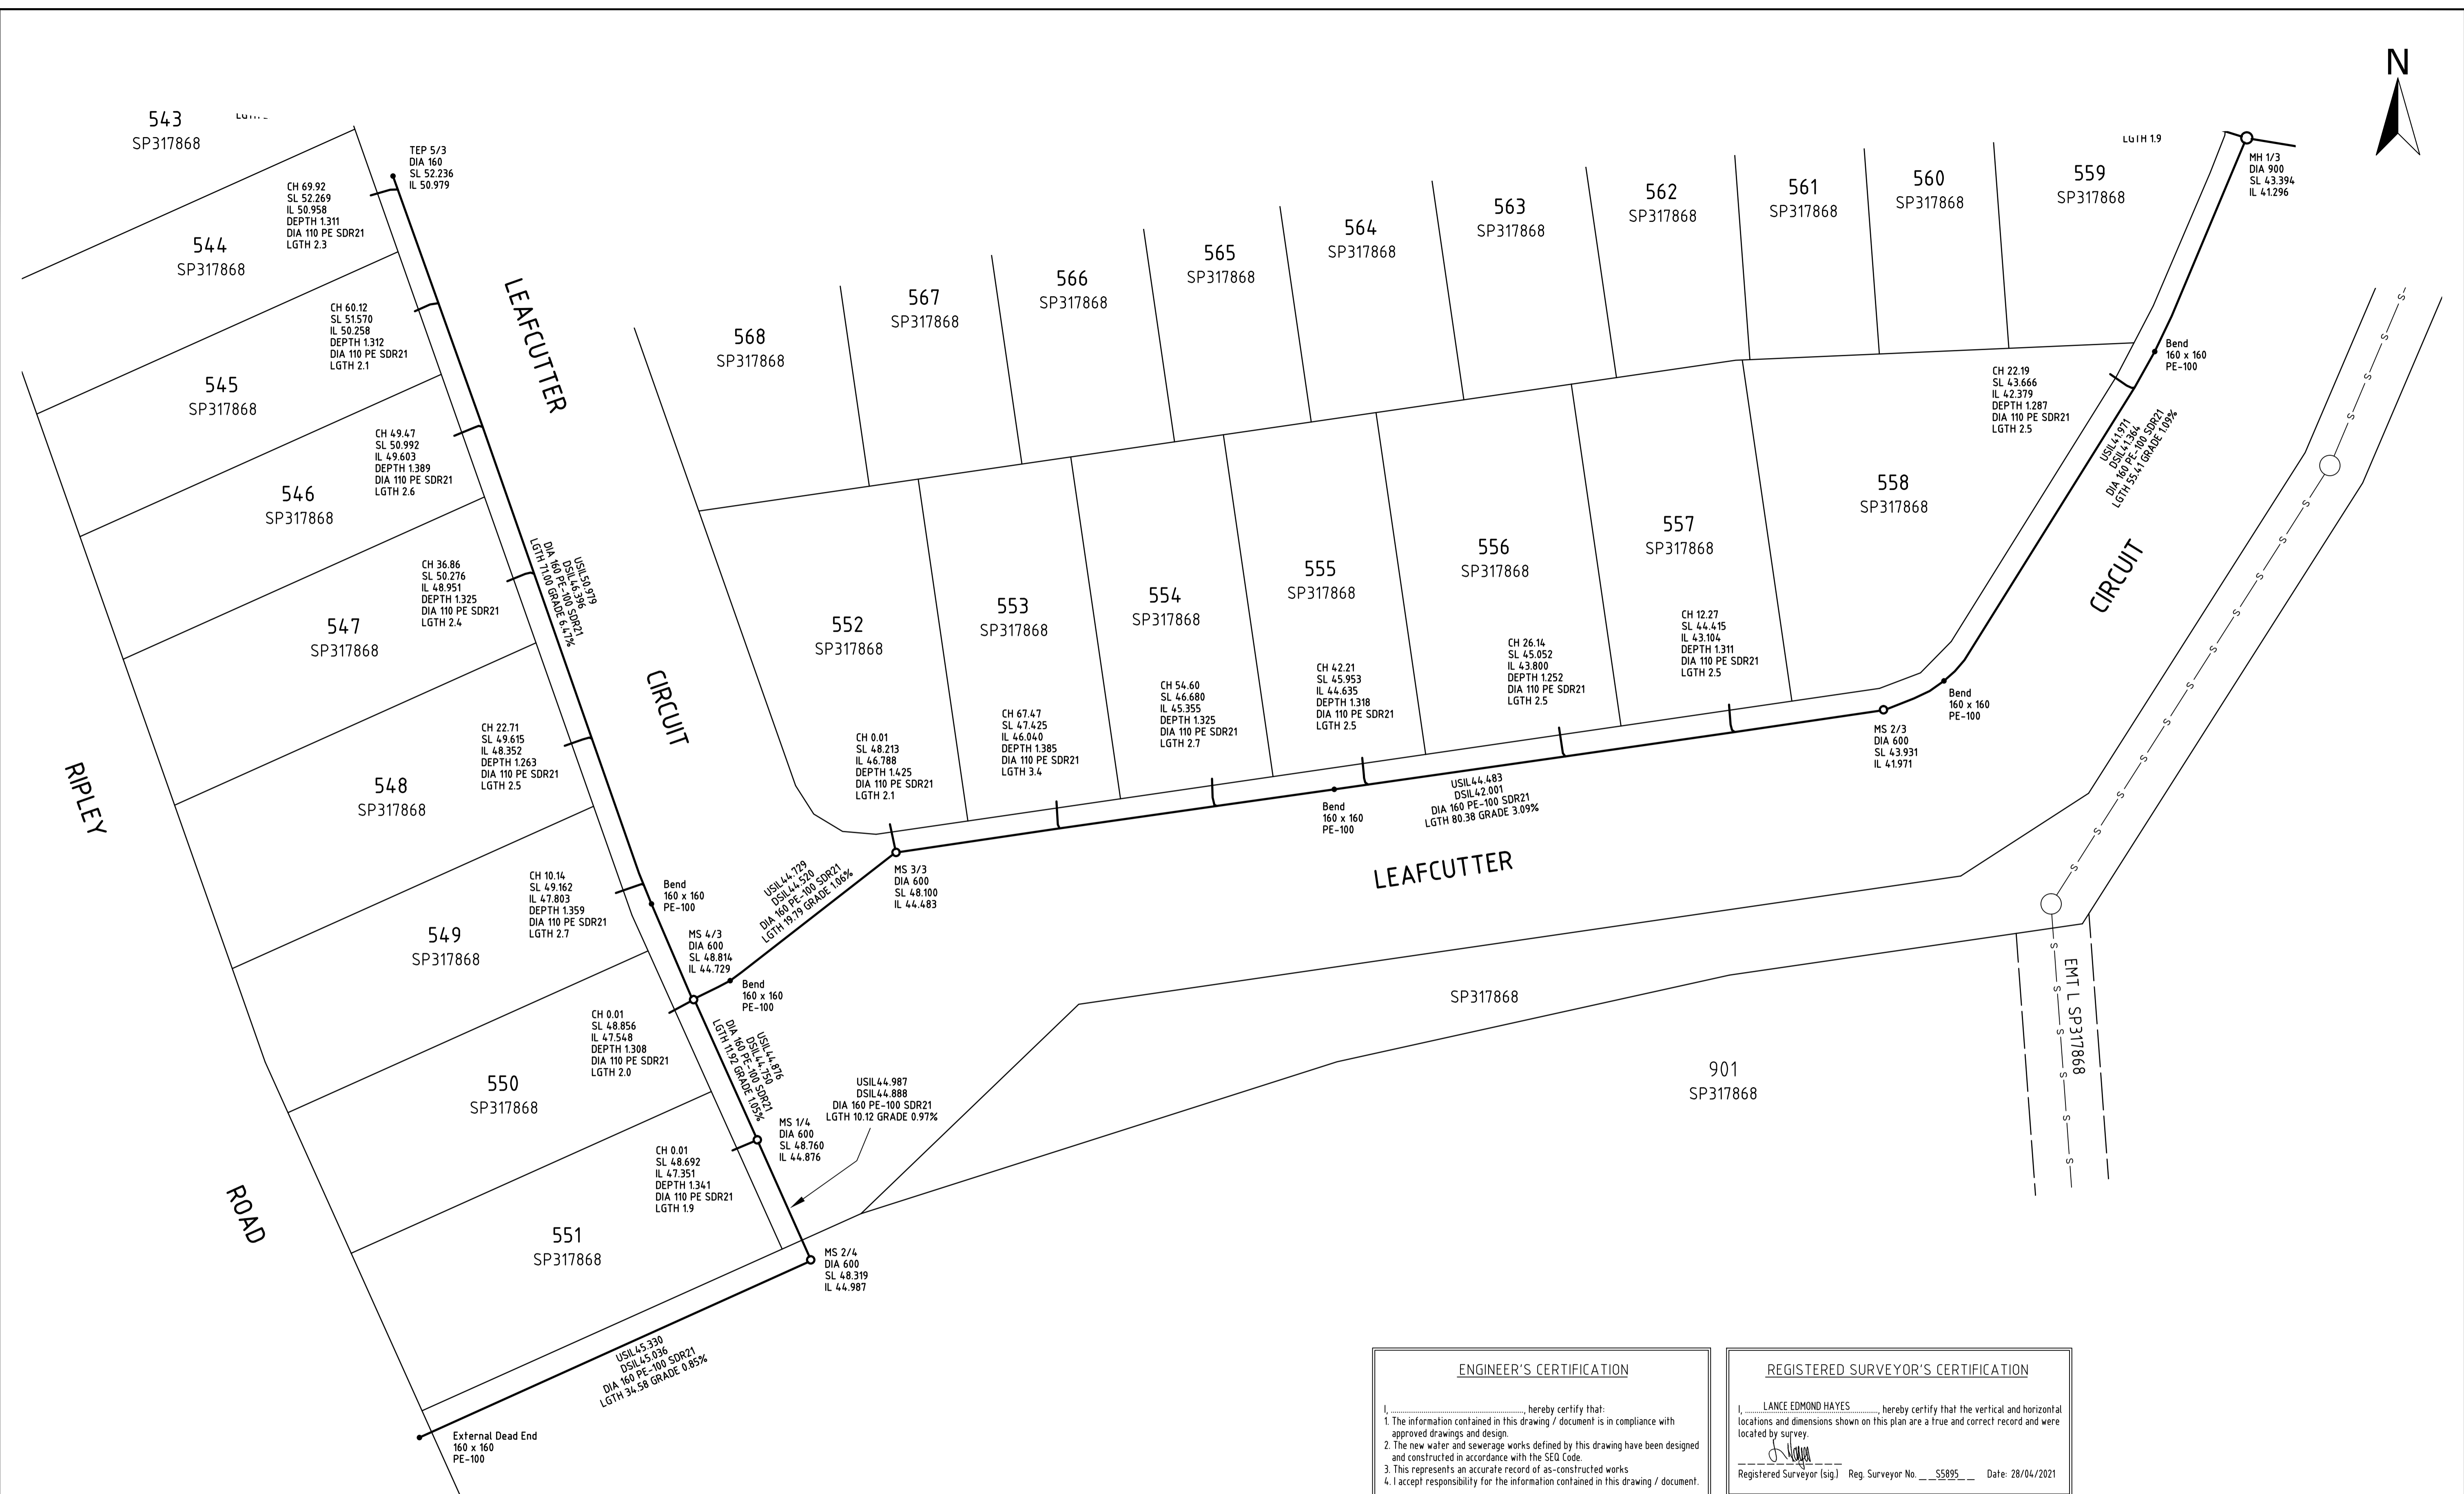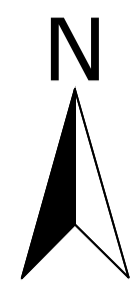


ENGINEER'S CERTIFICATION

I, _____, hereby certify that:
 1. The information contained in this drawing / document is in compliance with approved drawings and design.
 2. The new water and sewerage works defined by this drawing have been designed and constructed in accordance with the SEQ Code.
 3. This represents an accurate record of as-constructed works
 4. I accept responsibility for the information contained in this drawing / document.


 RPEQ (signature) RPEQ No. _____ Date: _____

REGISTERED SURVEYOR'S CERTIFICATION

I, LANCE EDMOND HAYES, hereby certify that the vertical and horizontal locations and dimensions shown on this plan are a true and correct record and were located by survey.

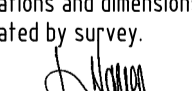
 Registered Surveyor (sig.) Reg. Surveyor No. 55895 Date: 28/04/2021

AS CONSTRUCTED

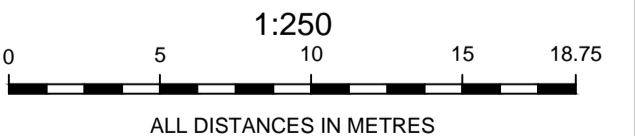

A1	1					
	1	28/04/2021	ORIGINAL ISSUE			
	INDEX	DATE	REVISIONS	DRAWN	CHECKED	PASSED

DRAWN	QSD	28/04/2021
CHECKED	BDG	28/04/2021
PASSED	BDG	28/04/2021
	INITIALS	DATE



Queensland Urban Utilities

AS CONSTRUCTED SEWER
 HAYFIELD STAGE 5
 352 RIPLEY ROAD, RIPLEY

SCALE	1:250
SHEET	3 OF 4 SHEETS
DRAWING NO.	3366-0027-29-SEW



REGISTERED SURVEYOR'S CERTIFICATION

I, LANCE EDMOND HAYES, hereby certify that the vertical and horizontal locations and dimensions shown on this plan are a true and correct record and were located by survey.


[Signature]
Registered Surveyor (sig) Reg. Surveyor No. S5895 Date: 28/04/2021

ENGINEER'S CERTIFICATION

I, _____, hereby certify that:

- The information contained in this drawing / document is in compliance with approved drawings and design.
- The new water and sewerage works defined by this drawing have been designed and constructed in accordance with the SEQ Code.
- This represents an accurate record of as-constructed works.
- I accept responsibility for the information contained in this drawing / document.

RPEQ (signature) RPEQ No. _____ Date: _____

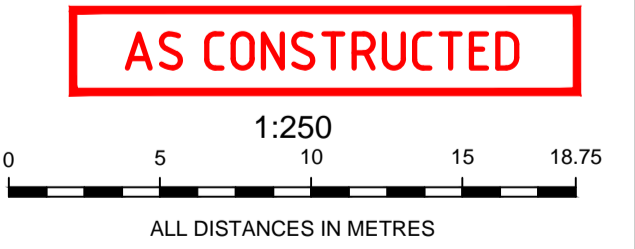

AS CONSTRUCTED

A1	1								
	1	28/04/2021	ORIGINAL ISSUE						
	INDEX	DATE	REVISIONS	DRAWN	CHECKED	PASSED			

DRAWN	QSD	28/04/2021
CHECKED	BDG	28/04/2021
PASSED	BDG	28/04/2021
	INITIALS	DATE



Queensland Urban Utilities

AS CONSTRUCTED SEWER
HAYFIELD STAGE 5
352 RIPLEY ROAD, RIPLEY

SCALE	1:250
SHEET	4 OF 4 SHEETS
DRAWING NO.	3366-0027-29-SEW