

Amendments		DETAILS
ISSUE	DATE	INITIAL VERSION
A	27/04/2021	

PLAN:
PLAN OF AS CONSTRUCTED DRAINAGE
 HAYFIELD STAGE 5
 352 RIPLEY ROAD
 RIPLEY

OPW NUMBER: -
 LGA: IPSWICH CITY
 SUBURB: RIPLY
 ORIGIN: SITE BM
 RL AHD

SCALE: 1:250
 DATUM: AHD
 DATE OF SURVEY: 06/04/2021
 SURVEYED BY: SURVEY MARK
 DRAWN BY: QSD

CLIENT: RIPLEY PROJECTS PTY LTD
 PLAN REFERENCE: 3366-0027-29-SW

SHEET 1 OF 2
 ISSUE A

REGISTERED SURVEYOR'S CERTIFICATION
 I, LANCE EDMOND HAYES, hereby certify that the vertical and horizontal locations and dimensions shown on this plan are a true and correct record and were located by survey.
 Registered Surveyor (sig) Reg. Surveyor No. 55895 Date: 27/04/2021

ENGINEER'S CERTIFICATION
 I, _____, hereby certify that:
 1. The information contained in this drawing / document is in compliance with approved drawings and design.
 2. The new water and sewerage works defined by this drawing have been designed and constructed in accordance with the SEQ Code.
 3. This represents an accurate record of as-constructed works
 4. I accept responsibility for the information contained in this drawing / document.
 RPEQ (signature) RPEQ No. _____ Date: _____

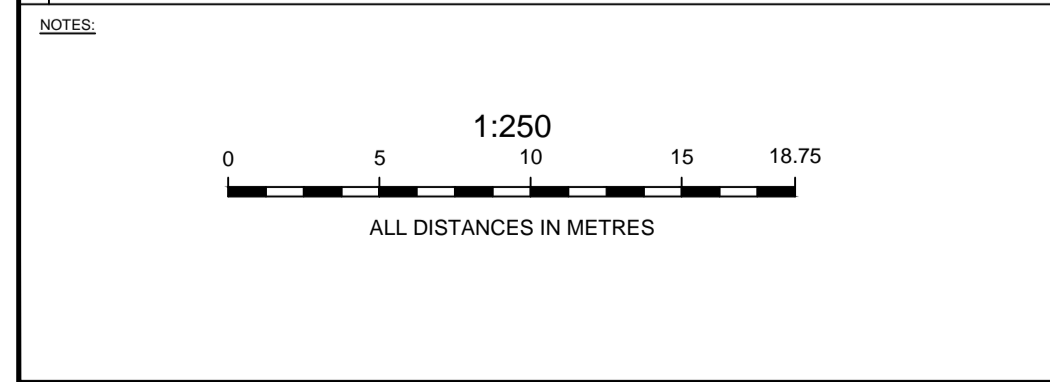


Table of mm
10 20 30 40 50 60 70 80 90 100 110 120 130 140 150 160 170 180 190 200 210 220 230 240 250 260 270 280 290 300 310 320 330 340 350 360 370 380 390 400 410 420 430 440



REGISTERED SURVEYOR'S CERTIFICATION
 I, LANCE EDMOND HAYES, hereby certify that the vertical and horizontal locations and dimensions shown on this plan are a true and correct record and were located by survey.
 Registered Surveyor (sig.) Reg. Surveyor No. 55895 Date: 27/04/2021

ENGINEER'S CERTIFICATION
 I, _____, hereby certify that:
 1. The information contained in this drawing / document is in compliance with approved drawings and design.
 2. The new water and sewerage works defined by this drawing have been designed and constructed in accordance with the SEO Code.
 3. This represents an accurate record of as-constructed works
 4. I accept responsibility for the information contained in this drawing / document.
 RPEQ (signature) RPEQ No. _____ Date: _____



Amendments		DETAILS
ISSUE	DATE	INITIAL VERSION
A	27/04/2021	

PLAN:
PLAN OF AS CONSTRUCTED DRAINAGE
 HAYFIELD STAGE 5
 352 RIPLEY ROAD
 RIPLEY

OPW NUMBER: _____
 LGA: IPSWICH CITY
 SUBURB: RIPLEY
 ORIGIN: SITE BM
 RL AHD

SCALE: 1:250
 DATUM: AHD
 DATE OF SURVEY: 06/04/2021
 SURVEYED BY: SURVEY MARK
 DRAWN BY: QSD

CLIENT: RIPLEY PROJECTS PTY LTD
 PLAN REFERENCE: 3366-0027-29-SW

SHEET 1 OF 2
 ISSUE A